6147888 - Screw, Filler, Oil Buffer Tube Assy.c4

B 6147888

HEAT TREATMENT & FINAL FINISH

~~DO~~ DO NOT INSCRIBE PART NO. (6)

BODY-5153206 (A1)

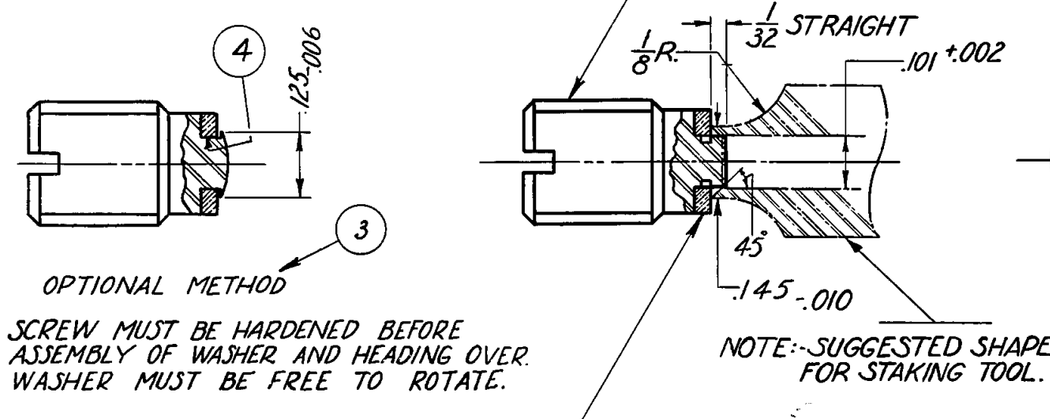

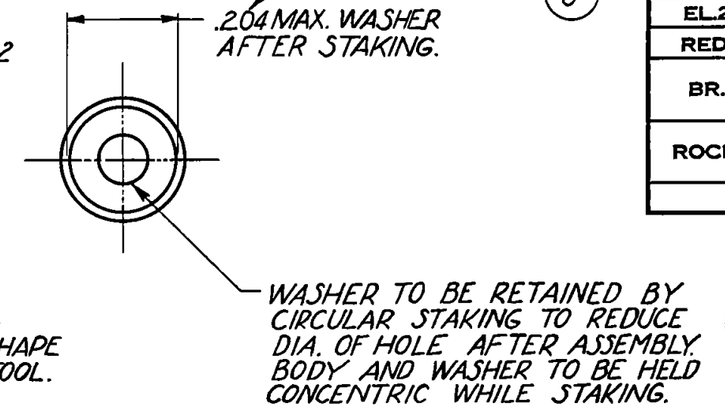

PHYSICAL PROPERTIES	
Y.P.	
T.S.	
EL.2	
RED.	
BR.	
ROCK.	

JULY 14, 1943.

REVISIONS

1	10-12-43	9'	10-28-53
2	11-2-43	A3	SEE EO HQMD 00173 4 AUG 70
3²	1-1-44	B1	SEE ERR
4²	4-17-44		HQR
5'	2-10-45		20008-1
6⁴	CONVERSION 1-12-49	C-M	14 JAN 72
7'	MODERNIZATION 9-27-51	C 40639	SEE ERR HQR 18 FEB 75
8'	9-25-53		

DRG. PERTAINS TO

~~C4077~~	~~BUFFER, OIL, ASM.~~
~~C4078~~	~~BUFFER, OIL, ASM.~~
~~51133~~	~~.50 B.M.G. T36~~
D5504077	.50BMG-M2AC BASIC
	.50BMG-M2WC FLEX
	M G CAL .50, XM218
	XM213
	GUN, ACFT,
	CAL .50, GAU-10/A

LIST OF COMPONENTS

LINE NUMBER	DRAWING NUMBER OR PIECE MARK	NAME OF COMPONENT	NO. REQUIRED PER UNIT ASM.
1	B147888	SCREW, FILLER, OIL BUFFER TUBE, ASSEMBLY	2
2		COMPOSED OF:-	
3	A153206	1-BODY, SCREW, FILLER, OIL BUFFER TUBE *	
4	A153207	1-WASHER, SCREW, FILLER, OIL BUFFER TUBE *	
5			
6			

SCREW, FILLER, OIL BUFFER TUBE, ASSEMBLY 6147888 (B147888 4)

~~*WILL NOT BE ISSUED FOR FIELD MAINTENANCE EXCEPT AS COMPONENTS OF AUTHORIZED ASSEMBLIES.~~

FOR LIST OF PARTS, SEE EPL 6147888

0 INCHES

SUPERSEDES OLD TRACING B147888 UNDER REVISION DATE OF OCT. 12, 1943. (A3)

SPRINGFIELD ARMORY B6147888

~~B147888~~

D'FTSMAN	TRACER	L'DG. D'FTSMAN
K.T.	K.T.	WEG
CHECKER		CHIEF D'FTSMAN
W.F.M.		EJA

SUBMITTED:- E. J. Ambrose, ORD. ENG. ORD. DEPT.

APPROVED BY ORDER OF THE CHIEF OF ORDNANCE:- B. Whittaker, LT. COL. ORD. DEPT.

ORDNANCE DEPT., U.S.A.

SUPERSEDES B147888